


**RECORD DRAWING
SCALE: NOT TO SCALE**

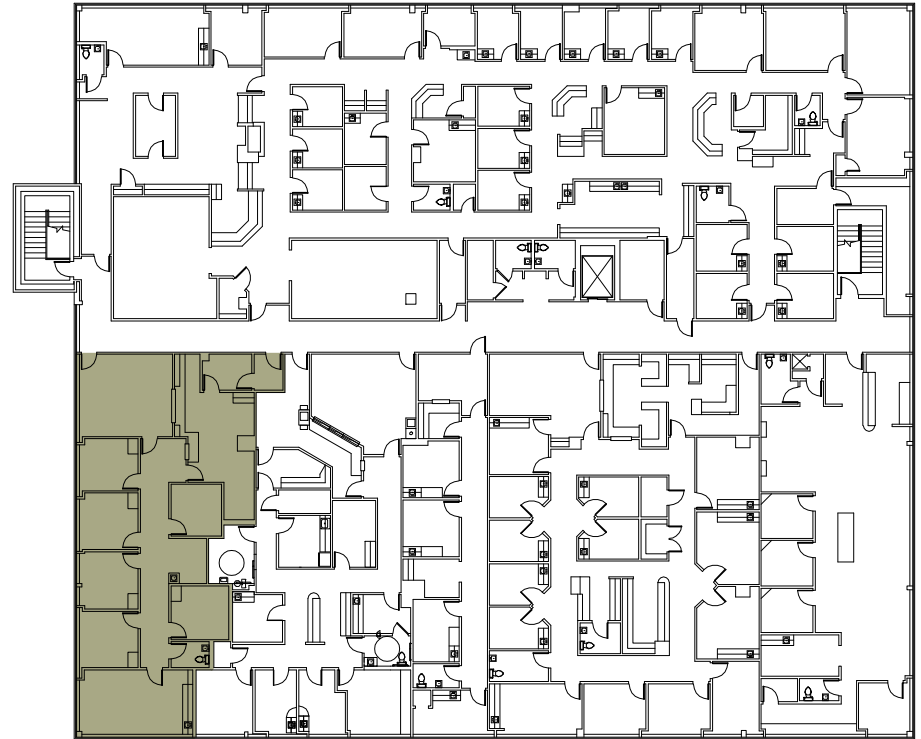

**KEY PLAN
NOT TO SCALE**



**BRENTWOOD MEDICAL CENTER
SUITE 200 - 2,245 USF / 2,447 RSF**



BRENTWOOD EAST - 343 FRANKLIN ROAD
SECOND FLOOR
BRENTWOOD, TENNESSEE

9819 OVERLOOK BLVD. . SUITE C-3 . BRENTWOOD, TN T - 615-620-4420 F - 615-620-4425 . www.aesashville.com