


**RECORD DRAWING  
SCALE: NOT TO SCALE**



**KEY PLAN  
NOT TO SCALE**

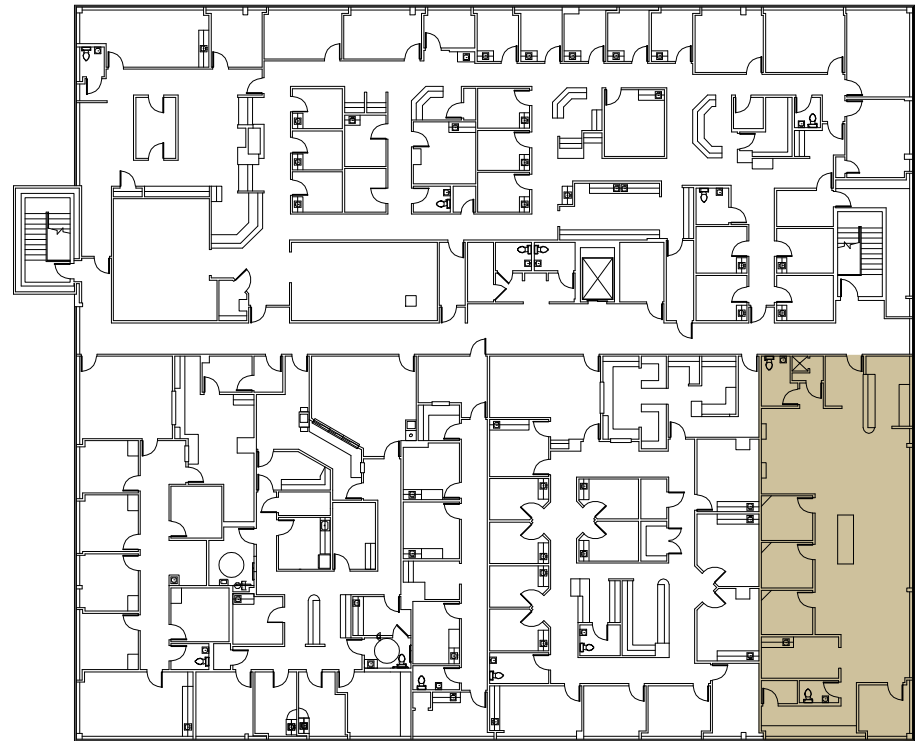

**BRENTWOOD MEDICAL CENTER  
SUITE 201 - 2,179 USF / 2,375 RSF**

**BRENTWOOD EAST - 343 FRANKLIN ROAD  
SECOND FLOOR  
BRENTWOOD, TENNESSEE**

**9019 OVERLOOK BLVD. . SUITE C-3 . BRENTWOOD, TN T - 615-620-4420 F - 615-620-4425 . www.aeashville.com**

