


RECORD DRAWING
SCALE: NOT TO SCALE

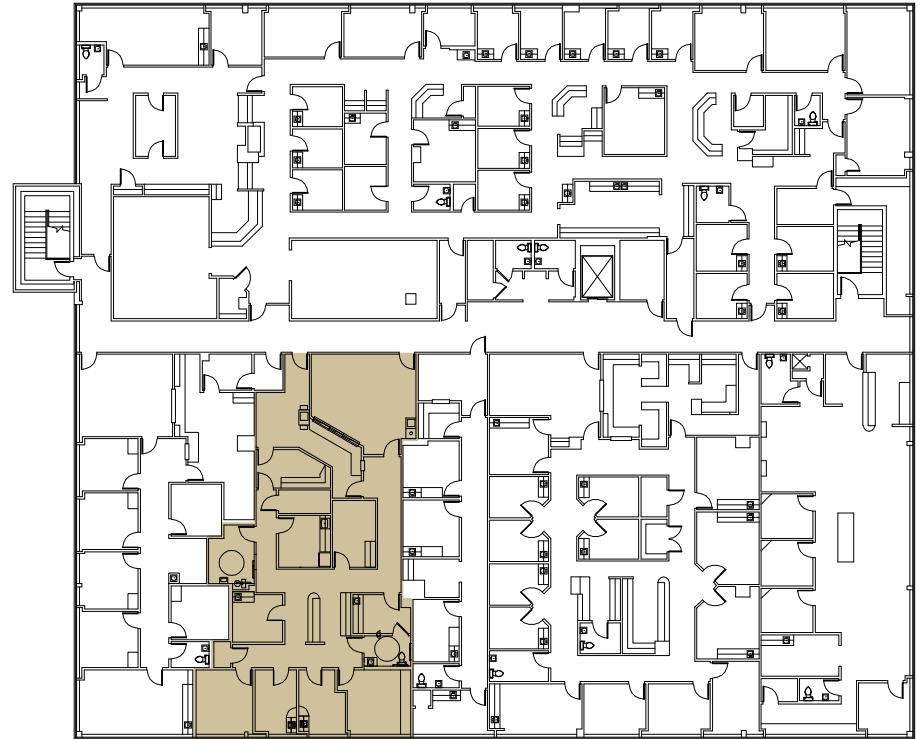

KEY PLAN
NOT TO SCALE



BRENTWOOD MEDICAL CENTER
SUITE 203 - 2,509 USF / 2,735 RSF



BRENTWOOD EAST - 343 FRANKLIN ROAD
SECOND FLOOR
BRENTWOOD, TENNESSEE

9819 OVERLOOK BLVD. . SUITE C-3 . BRENTWOOD, TN T - 615-620-4420 F - 615-620-4425 . www.aesashville.com