


**RECORD DRAWING
SCALE: NOT TO SCALE**



**KEY PLAN
NOT TO SCALE**

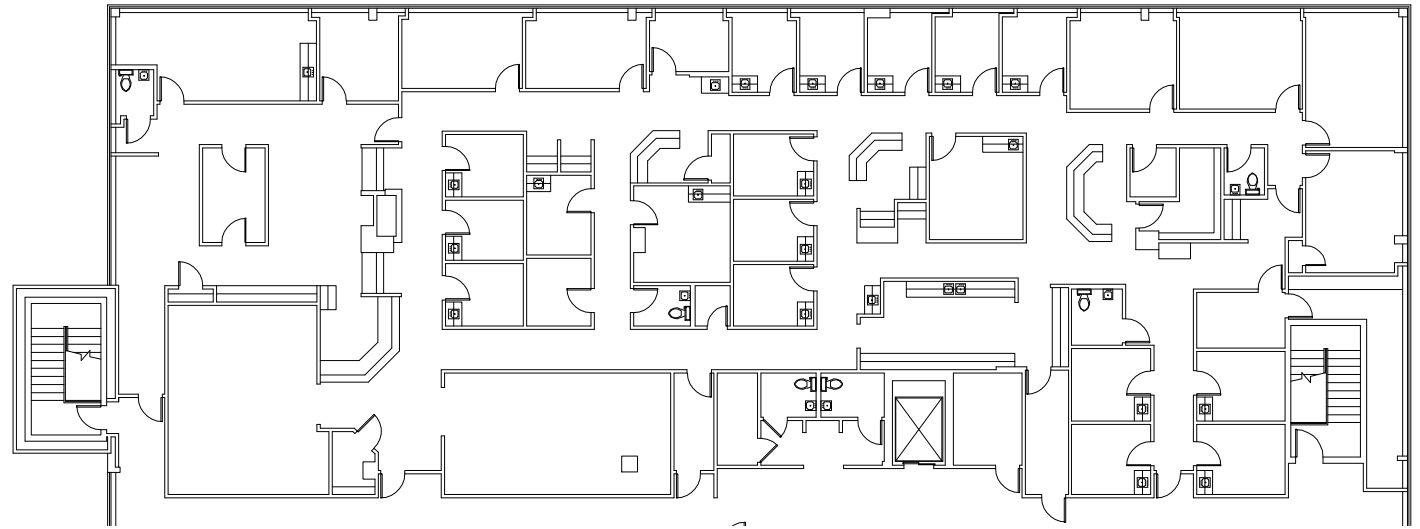

**BRENTWOOD MEDICAL CENTER
SUITE 210 - 8,853 USF / 9,650 RSF**



**BRENTWOOD EAST - 343 FRANKLIN ROAD
SECOND FLOOR
BRENTWOOD, TENNESSEE**

9919 OVERLOOK BLVD. . SUITE C-3 . BRENTWOOD, TN T - 615-620-4420 F - 615-620-4425 . www.gensshville.com