


KEY PLAN
NOT TO SCALE



RECORD DRAWING
1/16" SCALE

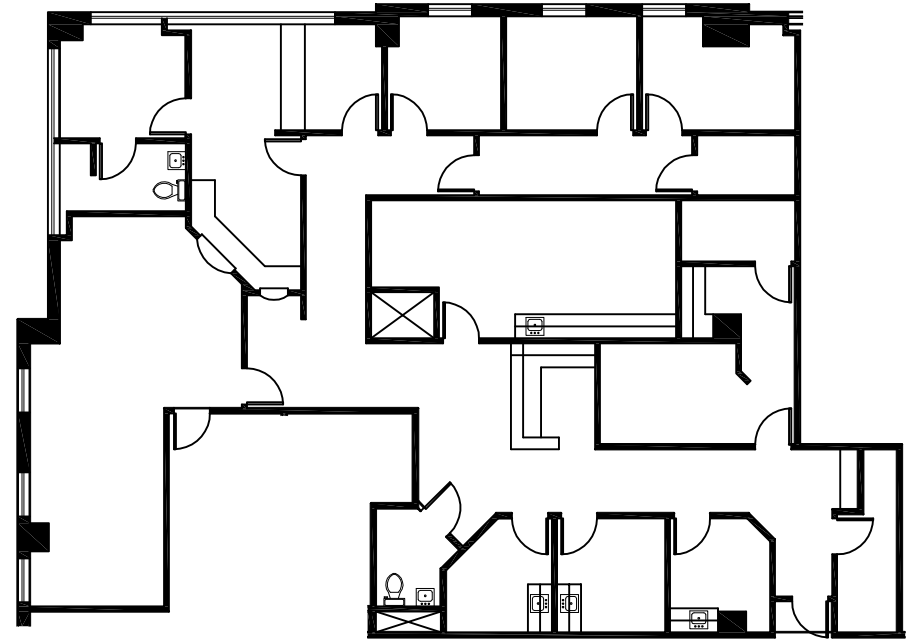

ELLIS MOB C
SUITE 240C - 2,951 USF / 3,305 RSF

NOT TO SCALE.



ELLIS MOB C
HENDERSONVILLE, TENNESSEE