


KEY PLAN
NOT TO SCALE



RECORD DRAWING
1/16" SCALE

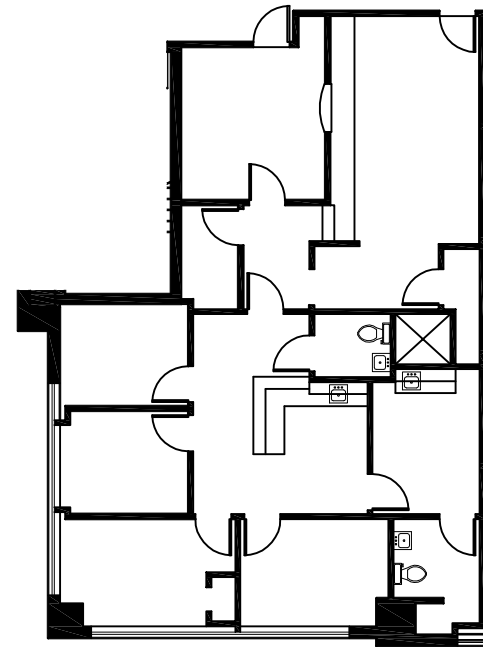

ELLIS MOB C
SUITE 241C - 1,529 USF / 1,712 RSF

NOT TO SCALE.



ELLIS MOB C
HENDERSONVILLE, TENNESSEE