


KEY PLAN
NOT TO SCALE



RECORD DRAWING
1/16" SCALE

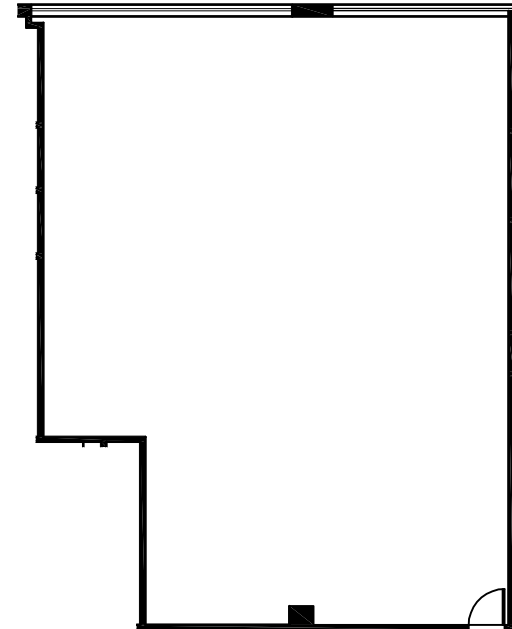

ELLIS MOB C
SUITE 242C - 1,872 USF / 2,097 RSF

NOT TO SCALE.



ELLIS MOB C
HENDERSONVILLE, TENNESSEE