


KEY PLAN
NOT TO SCALE

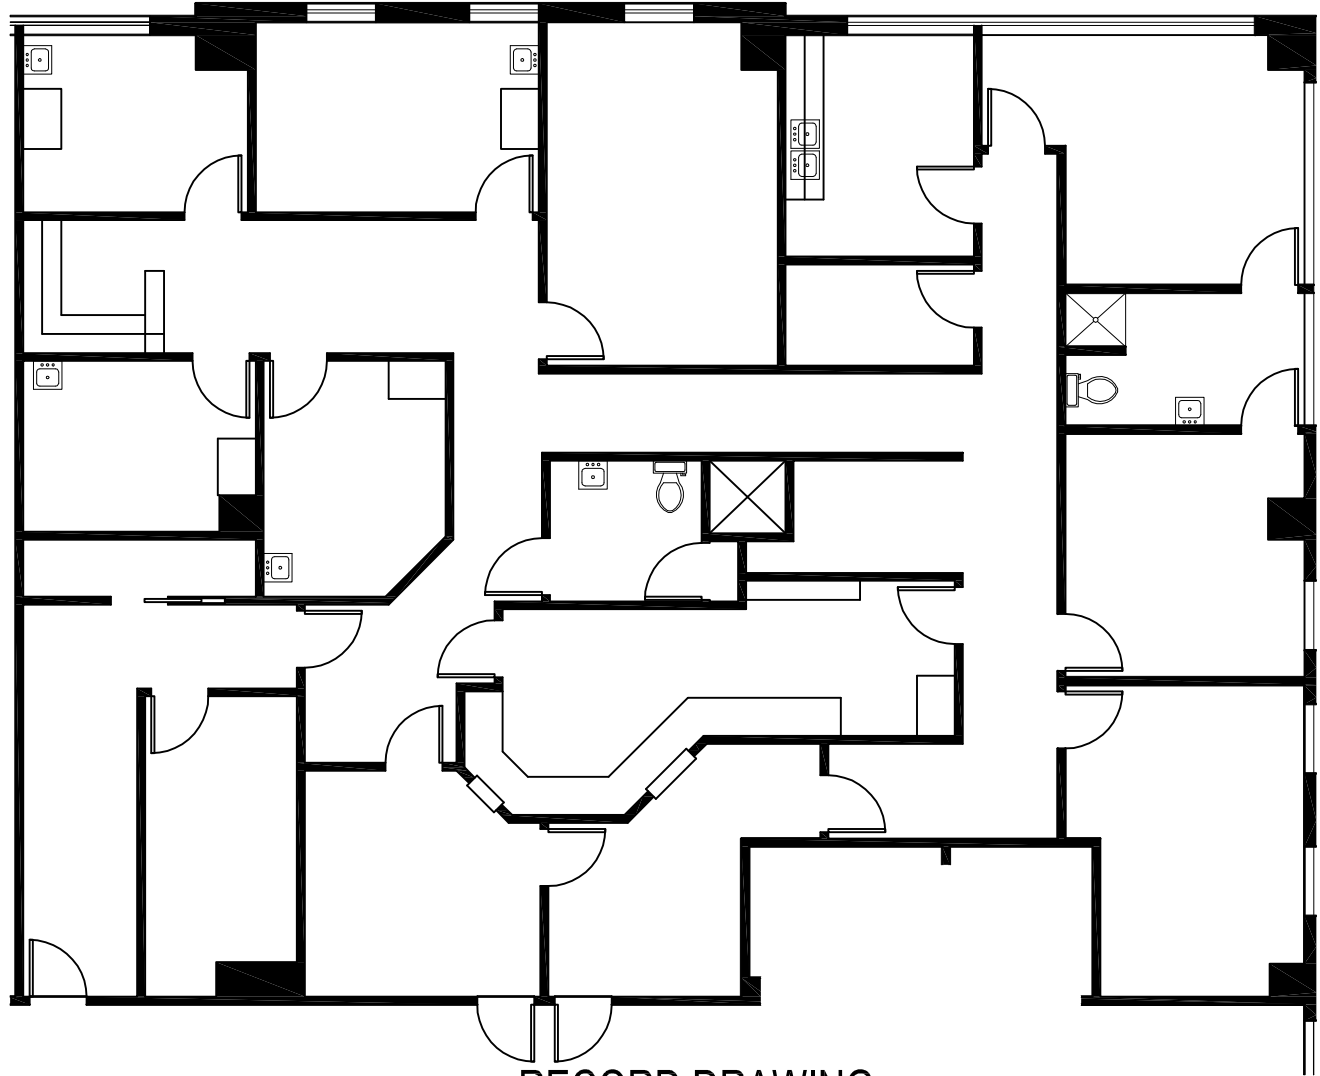

RECORD DRAWING
SCALE: NOT TO SCALE



NOT TO SCALE.



ELLIS MOB C
HENDERSONVILLE, TENNESSEE

ELLIS MOB C
SUITE 244C - 3,303 USF / 3,699 RSF