


KEY PLAN
NOT TO SCALE



RECORD DRAWING
NOT TO SCALE

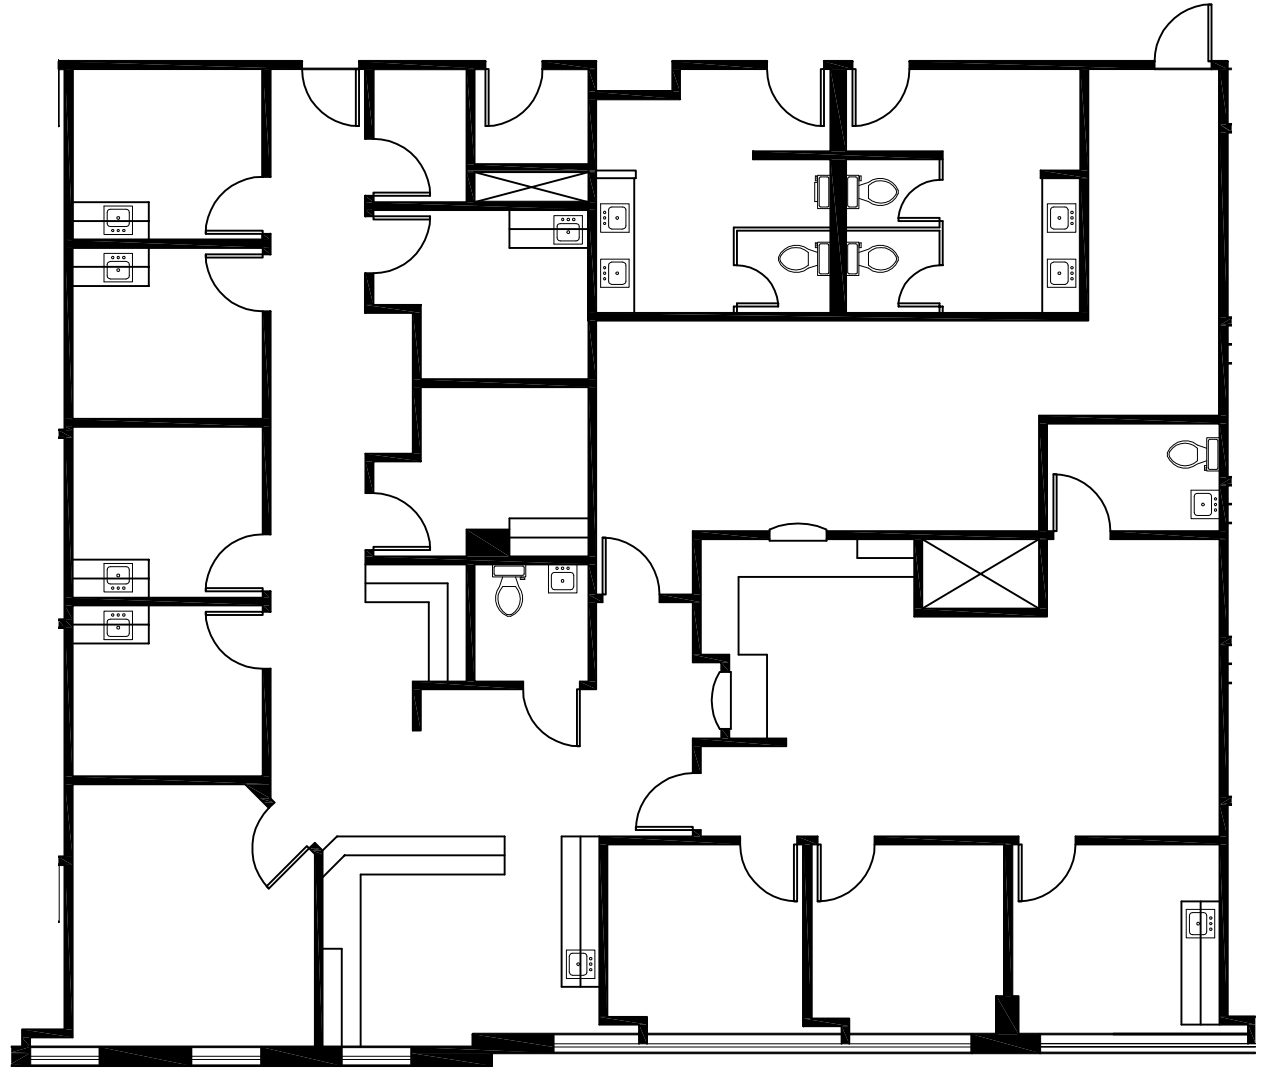

ELLIS MOB C
SUITE 245C - 2,735 USF / 3,063 RSF

NOT TO SCALE.



ELLIS MOB C
HENDERSONVILLE, TENNESSEE