



KEY PLAN
NOT TO SCALE

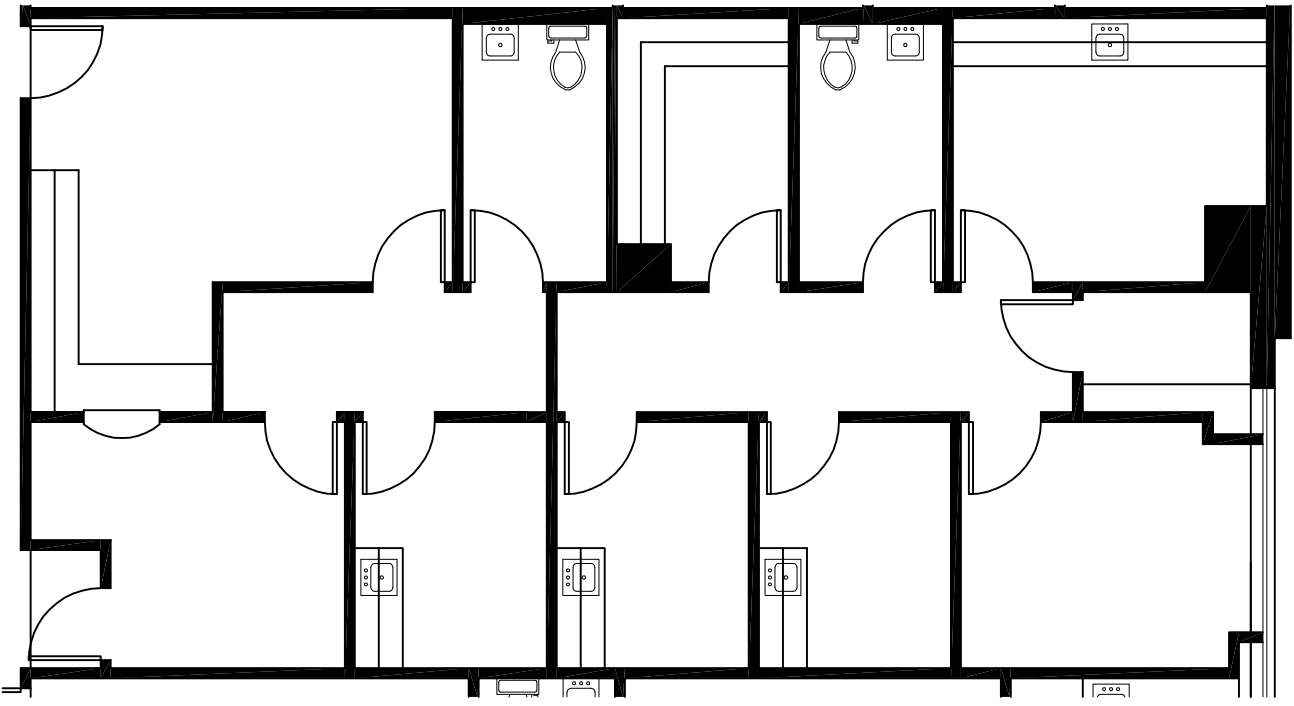

RECORD DRAWING
SCALE: 1/8" = 1'-0"

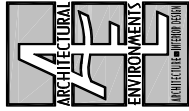

ELLIS MOB C
SUITE 247C - 1,401 USF / 1,569 RSF

NOT TO SCALE.



ELLIS MOB C
HENDERSONVILLE, TENNESSEE

9019 OVERLOOK BLVD. . SUITE C-3 . BRENTWOOD, TN T - 615-620-4420 F - 615-620-4425 . WWW.AENASHVILLE.COM