


KEY PLAN
NOT TO SCALE



RECORD DRAWING
1/16" SCALE

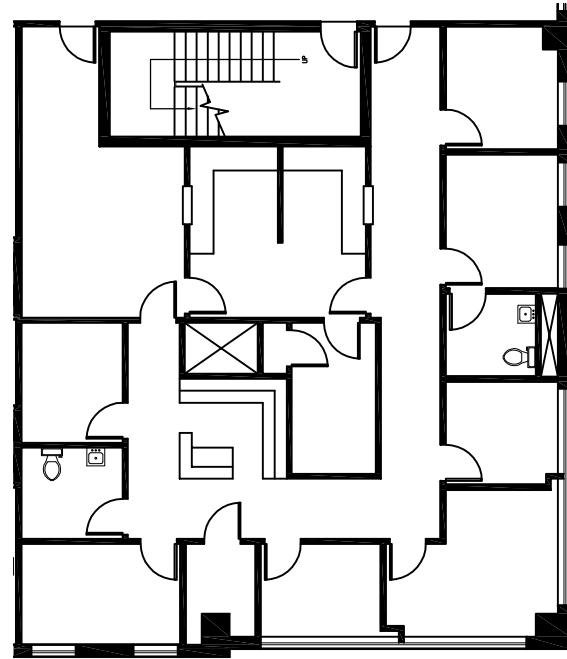

NOT TO SCALE.

ELLIS MOB C
SUITE 249C - 2,084 USF / 2,334 RSF



ELLIS MOB C
HENDERSONVILLE, TENNESSEE

9019 OVERLOOK BLVD. . SUITE C-3 . BRENTWOOD, TN T - 615-620-4420 F - 615-620-4425 . WWW.AENASHVILLE.COM