




KEY PLAN
NOT TO SCALE



RECORD DRAWING
1/16" SCALE

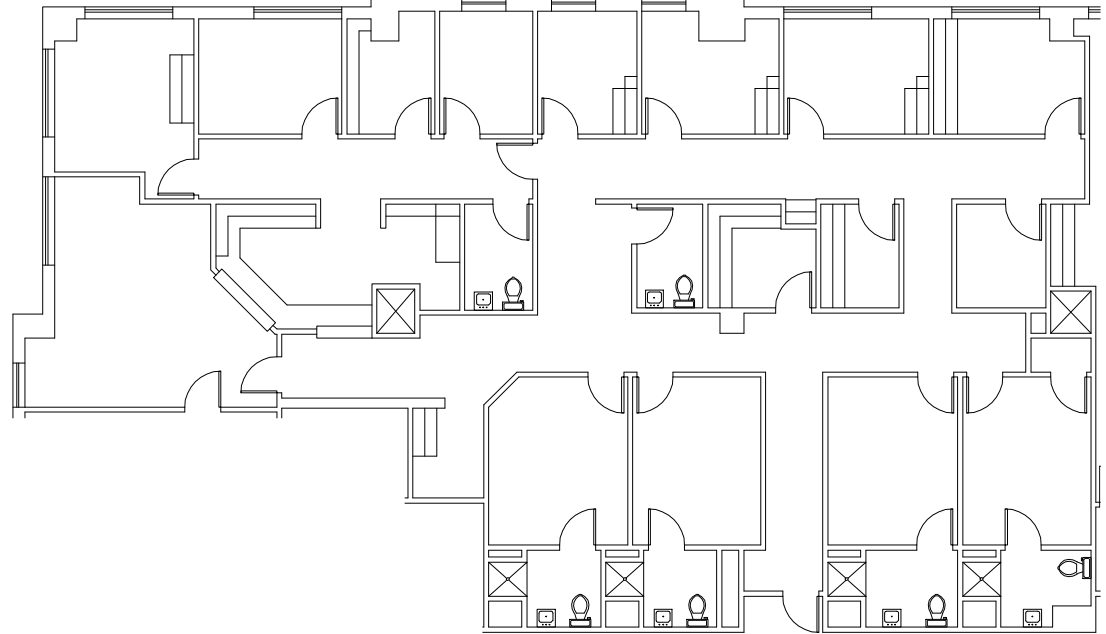

SCALE: VARIES



ELLIS MOB C
HENDERSONVILLE, TN

9019 OVERLOOK BLVD. . SUITE C-3 . BRENTWOOD, TN T - 615-620-4420 F - 615-620-4425 . www.genesville.com