




KEY PLAN  
NOT TO SCALE



RECORD DRAWING  
NOT TO SCALE

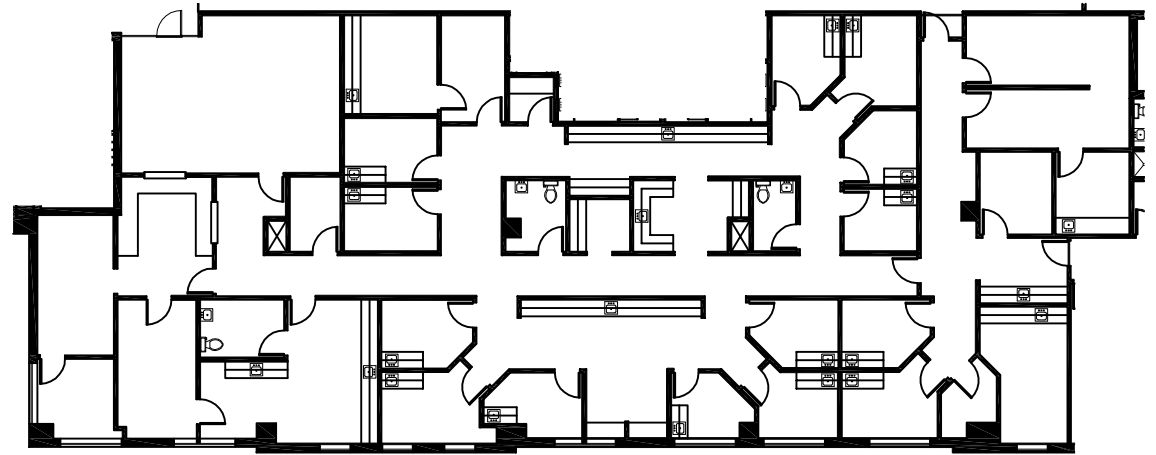

SCALE: VARIES



ELLIS MOB C  
SUITE 141C - 5,872 USF / 6,577 RSF

ELLIS MOB C  
HENDERSONVILLE, TN

9019 OVERLOOK BLVD. . SUITE C-3 . BRENTWOOD, TN T - 615-620-4420 F - 615-620-4425 . www.aenashville.com