


**KEY PLAN**  
NOT TO SCALE



**RECORD DRAWING**  
1/16" SCALE

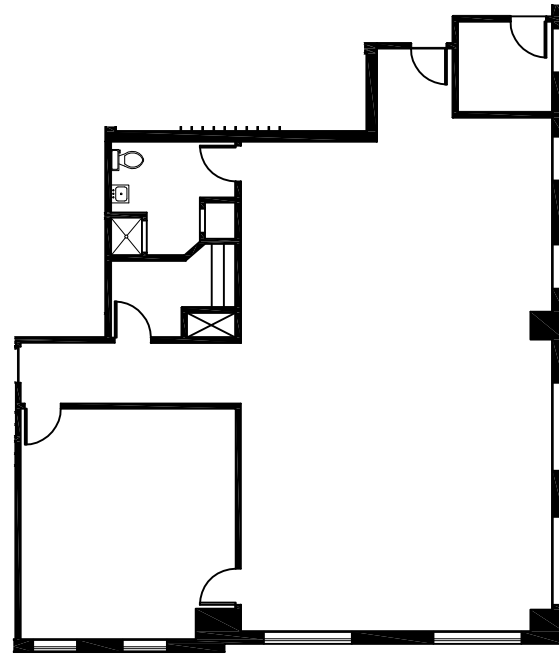

SCALE: VARIES

**ELLIS MOB C**  
**SUITE 142C - 1,779 USF / 1,992 RSF**



ELLIS MOB C  
HENDERSONVILLE, TN

9019 OVERLOOK BLVD. . SUITE C-3 . BRENTWOOD, TN T - 615-620-4420 F - 615-620-4425 . www.aenashville.com