


KEY PLAN
NOT TO SCALE



RECORD DRAWING
1/32" SCALE

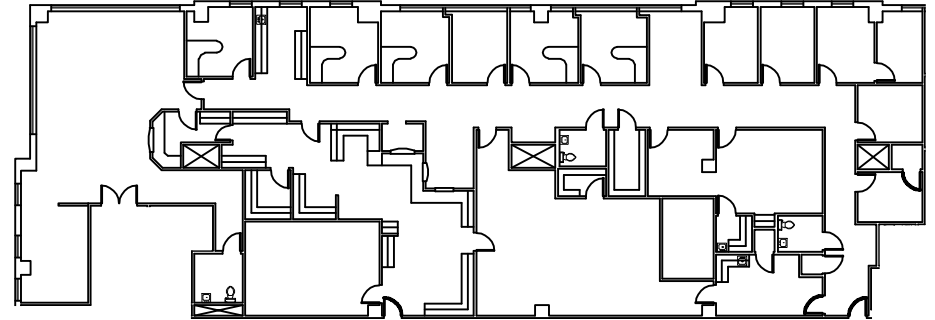

FILE: BASE BUILDINGS
SCALE: NOT TO SCALE



ELLIS MOB C
SUITE 300C - 7,097 USF / 7,948 RSF

ELLIS MOB C
353 NEW SHACKLE ISLAND ROAD
HENDERSONVILLE, TENNESSEE

9019 OVERLOOK BLVD. . SUITE C-3 . BRENTWOOD, TN T - 615-820-4420 F - 615-820-4425 . WWW.AENASHVILLE.COM