


KEY PLAN
NOT TO SCALE



RECORD DRAWING
1/16" SCALE

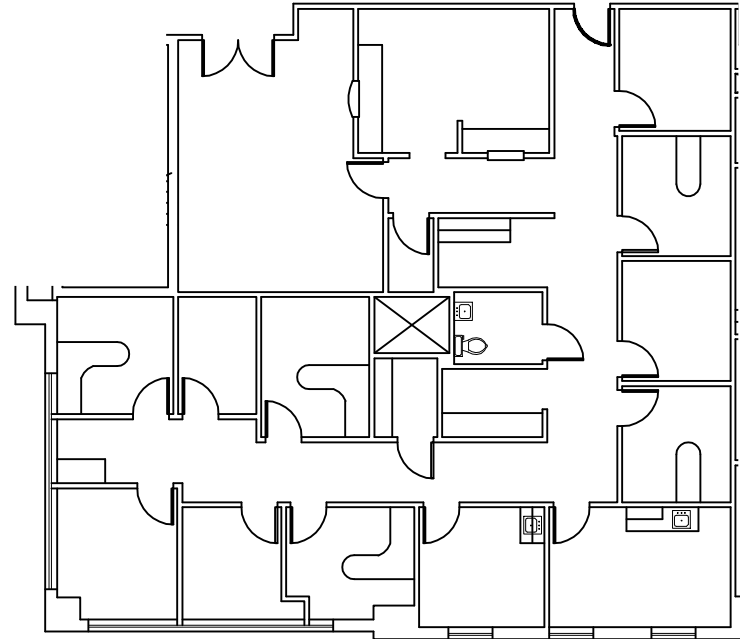

FILE: BASE BUILDINGS
SCALE: NOT TO SCALE



9019 OVERLOOK BLVD. . SUITE C-3 . BRENTWOOD, TN T - 615-620-4420 F - 615-620-4425 . WWW.AENASHVILLE.COM

ELLIS MOB C
SUITE 301C - 2,626 USF / 2,941 RSF

ELLIS MOB C
353 NEW SHACKLE ISLAND ROAD
HENDERSONVILLE, TENNESSEE