


KEY PLAN
NOT TO SCALE



RECORD DRAWING
1/16" SCALE

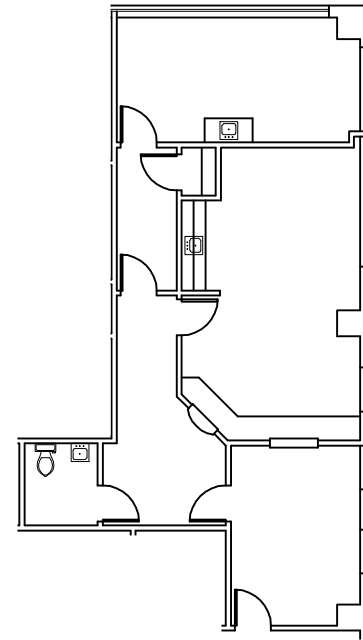

FILE: BASE BUILDINGS
SCALE: NOT TO SCALE



9919 OVERLOOK BLVD. . SUITE C-3 . BRENTWOOD, TN T - 615-620-4420 F - 615-620-4425 . WWW.AENASHVILLE.COM

ELLIS MOB C
SUITE 348C - 1,022 USF / 1,145 RSF

ELLIS MOB C
353 NEW SHACKLE ISLAND ROAD
HENDERSONVILLE, TENNESSEE