


KEY PLAN
NOT TO SCALE



RECORD DRAWING
NOT TO SCALE

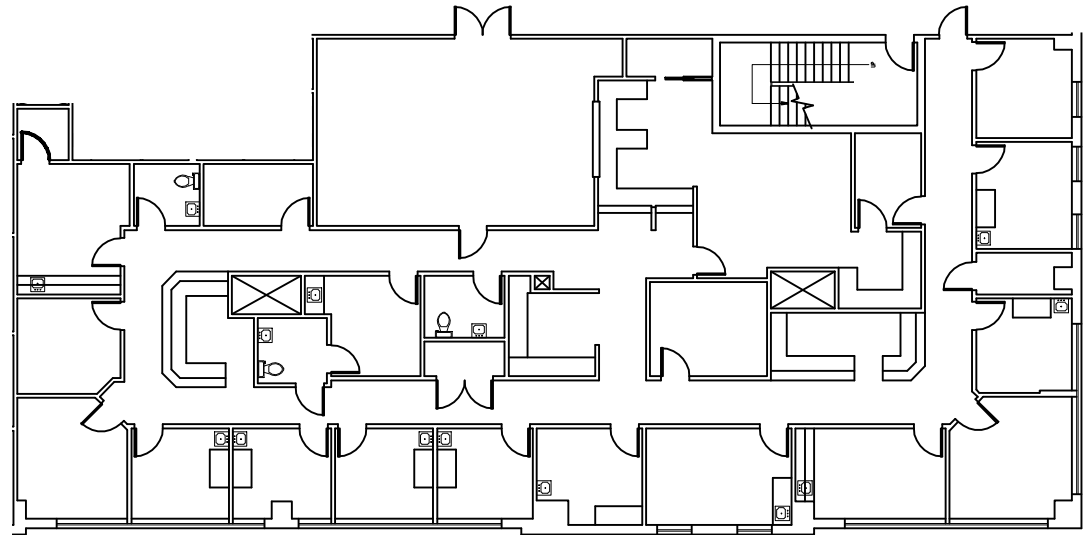

FILE: BASE BUILDINGS
SCALE: NOT TO SCALE

ELLIS MOB C
SUITE 341C - 5,120 USF / 5,734 RSF



ELLIS MOB C
353 NEW SHACKLE ISLAND ROAD
HENDERSONVILLE, TENNESSEE

9019 OVERLOOK BLVD. . SUITE C-3 . BRENTWOOD, TN T - 615-620-4420 F - 615-620-4425 . WWW.AENASHVILLE.COM