


RECORD DRAWING
NOT TO SCALE

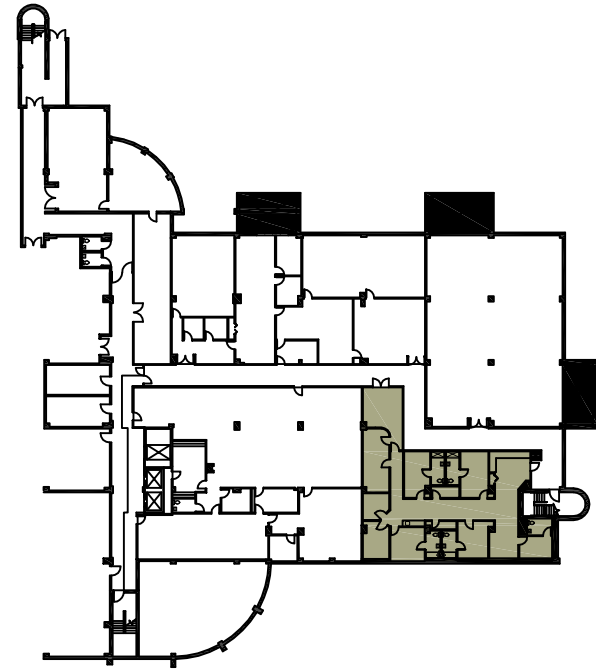

KEY PLAN
NOT TO SCALE



HORIZON MEDICAL CENTER - EAST
BASEMENT STE. 020 - 3,107 USF/ 3,480 RSF

SCALE: VARIES

* R.S.F. SHOWN IS BASED ON A 12% MARKET FACTOR.



HORIZON MEDICAL CENTER
111 HIGHWAY 70E
DICKSON, TENNESSEE

9019 OVERLOOK BLVD . SUITE C-3 . BRENTWOOD, TN T • 615-620-4420 F • 615-620-4425 . www.aenashville.com