


RECORD DRAWING
SCALE: 1/8" = 1'-0"

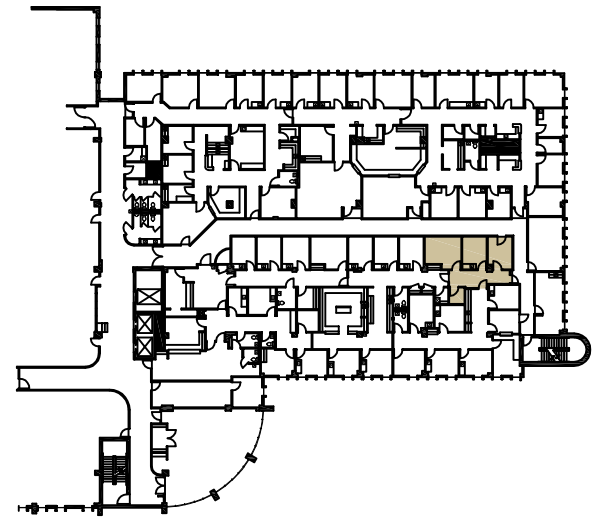

KEY PLAN
NOT TO SCALE



HORIZON MEDICAL CENTER - EAST SUITE F - 569 USF / 637 RSF

SCALE: VARIES

* R.S.F. SHOWN IS BASED ON A 12% MARKET FACTOR.



HORIZON MEDICAL CENTER
111 HIGHWAY 70E
DICKSON, TENNESSEE

9019 OVERLOOK BLVD. SUITE C-3 . BRENTWOOD, TN T - 615-620-4420 F - 615-620-4425 . www.aenashville.com