


RECORD DRAWING  
SCALE: NOT TO SCALE

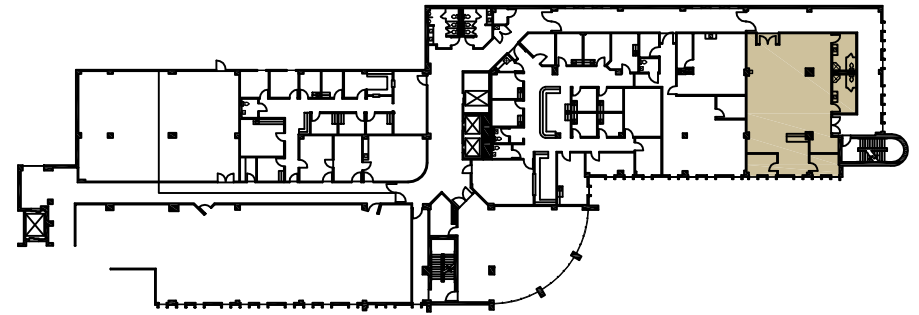

KEY PLAN  
NOT TO SCALE



HORIZON MEDICAL CENTER - EAST  
CARDIAC REHAB- 2,051 USF / 2,297 RSF

SCALE: VARIES  
\*R.S.F. SHOWN IS BASED ON A 12% MARKET FACTOR.



HORIZON MEDICAL CENTER  
111 HIGHWAY 70E  
DICKSON, TENNESSEE

9019 OVERLOOK BLVD . SUITE C-3 . BRENTWOOD, TN T - 615-620-4420 F - 615-620-4425 . www.aenashville.com