


RECORD DRAWING
SCALE: NOT TO SCALE



KEY PLAN
NOT TO SCALE

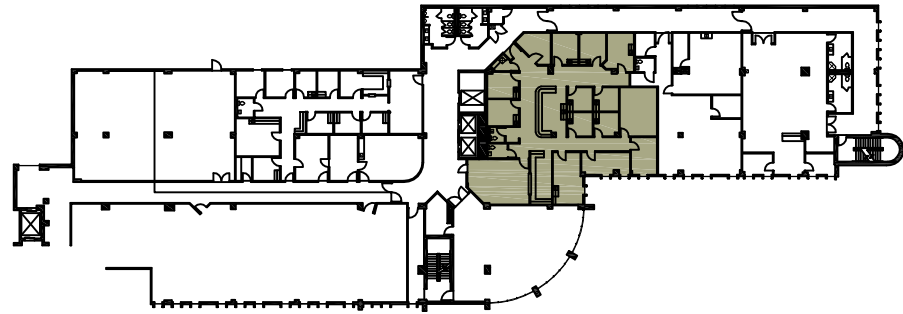

SCALE: VARIES
*R.S.F. SHOWN IS BASED ON A 12% MARKET FACTOR.



9019 OVERLOOK BLVD . SUITE C-3 . BRENTWOOD, TN T - 615-620-4420 F - 615-620-4425 . www.aenashville.com

HORIZON MEDICAL CENTER - EAST
SUITE B - 3,679 USF / 4,120 RSF

HORIZON MEDICAL CENTER
111 HIGHWAY 70E
DICKSON, TENNESSEE