


KEY PLAN
NOT TO SCALE



RECORD DRAWING
NOT SCALE

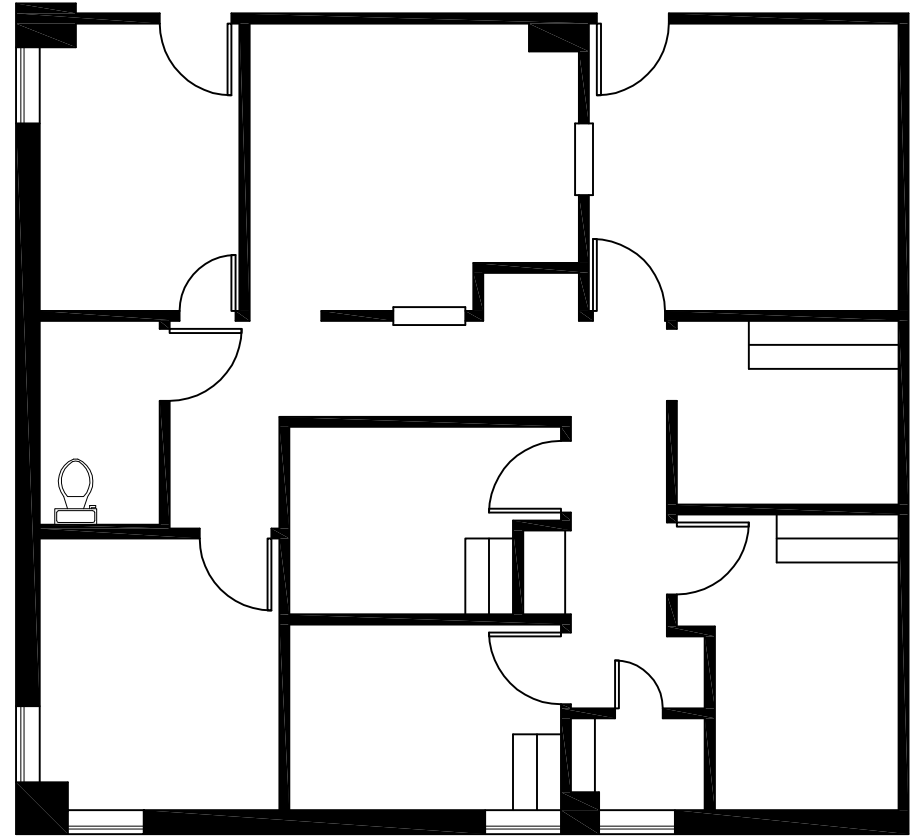

SOUTHERN HILLS M.O.B. BUILDING B
SUITE 207 - 1,190 USF / 1,433 RSF



391 WALLACE ROAD
NASHVILLE, TN

ARCHITECTURAL ENVIRONMENTS
9019 OVERLOOK BLVD. SUITE C-3 BRENTWOOD, TN 37027
www.aenashville.com