


KEY PLAN
NOT TO SCALE



RECORD DRAWING
NOT SCALE

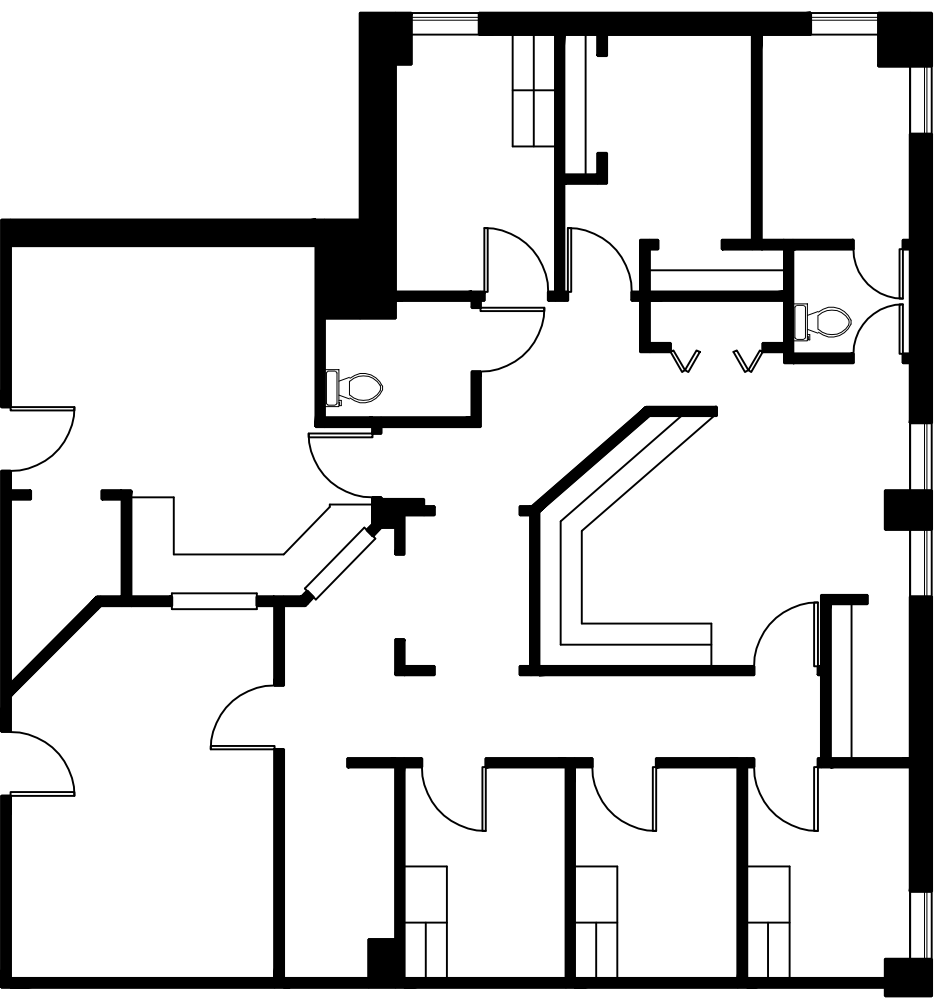

SOUTHERN HILLS M.O.B. BUILDING B
SUITE 210 - 1,709 USF / 1,914 RSF



385 WALLACE ROAD
NASHVILLE, TN

ARCHITECTURAL ENVIRONMENTS
9019 OVERLOOK BLVD. SUITE C-3 BRENTWOOD, TN 37027
www.aenashville.com