


KEY PLAN
NOT TO SCALE



RECORD DRAWING
NOT SCALE

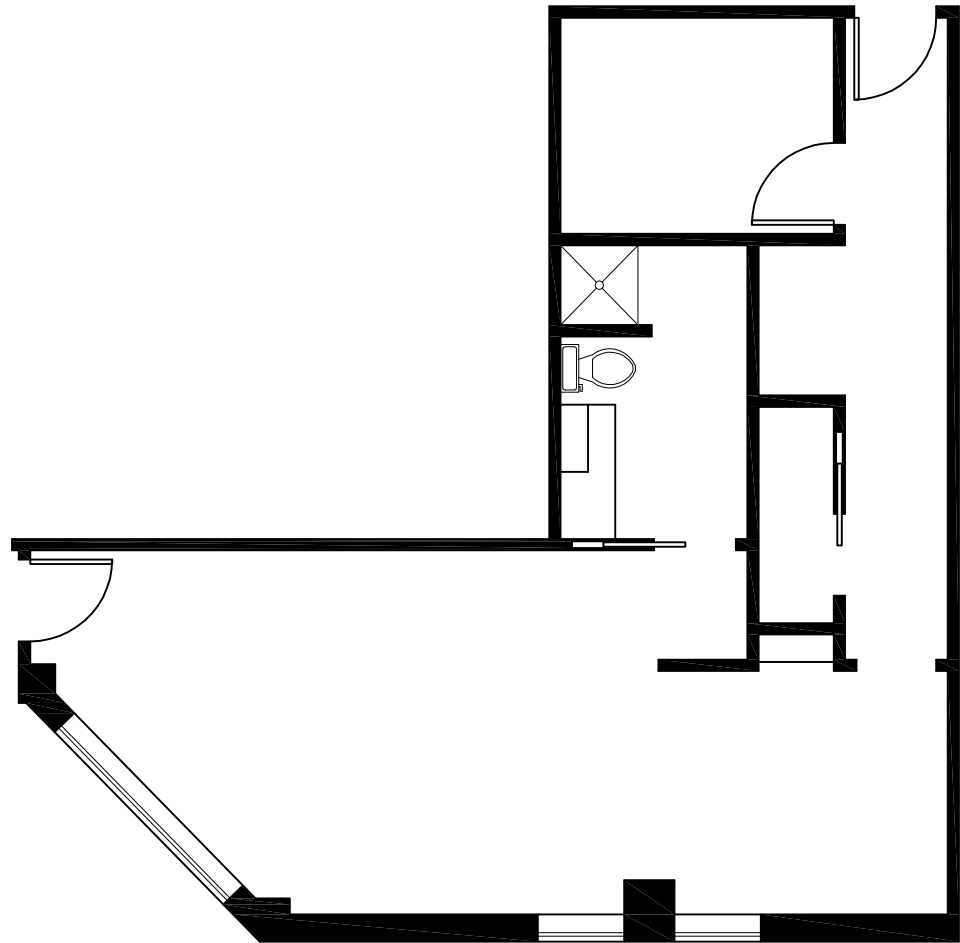

SOUTHERN HILLS M.O.B. BUILDING B
SUITE 302 - 698 USF / 850 RSF



391 WALLACE ROAD
NASHVILLE, TN

ARCHITECTURAL ENVIRONMENTS
9019 OVERLOOK BLVD. SUITE C-3 BRENTWOOD, TN 37027
www.aenashville.com