


KEY PLAN  
NOT TO SCALE



RECORD DRAWING  
NOT SCALE

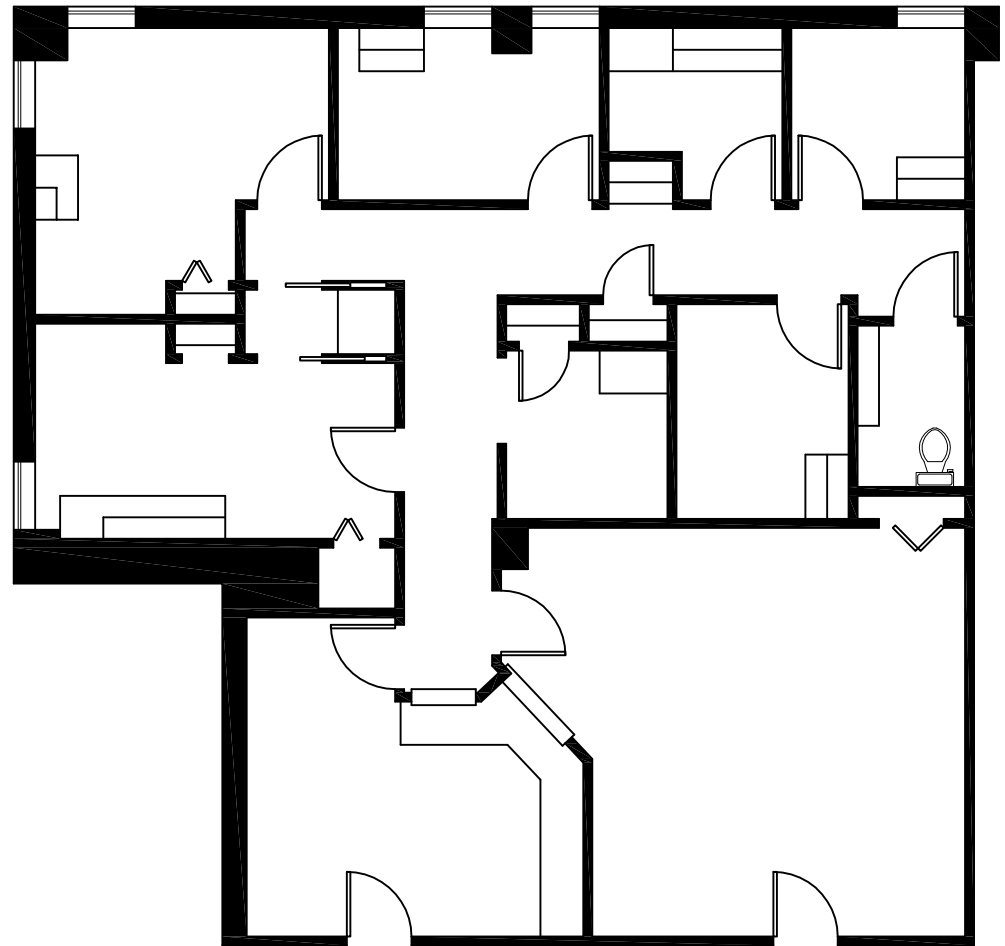

SOUTHERN HILLS M.O.B. BUILDING B  
SUITE 310 - 1,662 USF / 2,024 RSF



391 WALLACE ROAD  
NASHVILLE, TN

ARCHITECTURAL ENVIRONMENTS  
9019 OVERLOOK BLVD. SUITE C-3 BRENTWOOD, TN 37027  
[www.aenashville.com](http://www.aenashville.com)