




RECORD DRAWING  
NOT TO SCALE

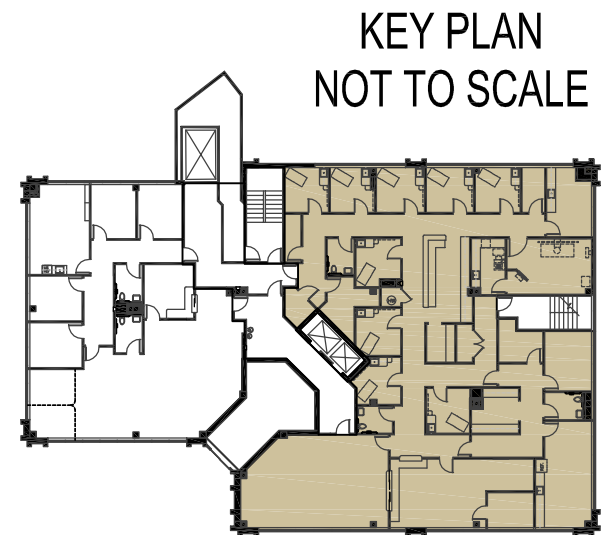

KEY PLAN  
NOT TO SCALE



356 BUILDING  
SUITE 200 - 5,204 USF / 5,936 RSF



SECOND FLOOR  
NASHVILLE, TN

9019 OVERLOOK BLVD. SUITE C-3. BRENTWOOD, TN T - 615-620-4420 F - 615-620-4425 . www.aenashville.com