


KEY PLAN
NOT TO SCALE



RECORD DRAWING
NOT TO SCALE

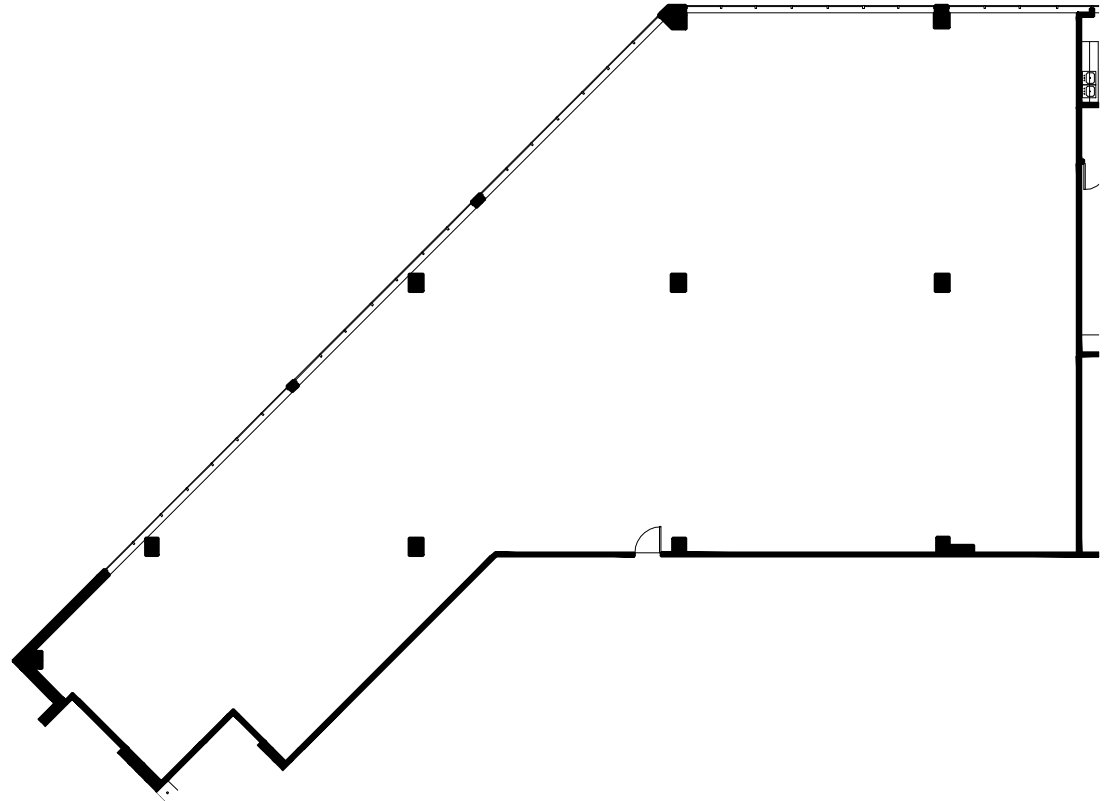

SCALE: VARIES



SKYLINE MADISON M.O.B.
MADISON, TENNESSEE

SKYLINE MADISON M.O.B.
SUITE VACANT 1 - 5,627 USF / 6,302 RSF

8819 OVERLOOK BLVD. . SUITE C-3 . BRENTWOOD, TN T - 615-620-4420 F - 615-620-4425 . www.aenashville.com