


KEY PLAN
NOT TO SCALE



RECORD DRAWING
1/16" SCALE

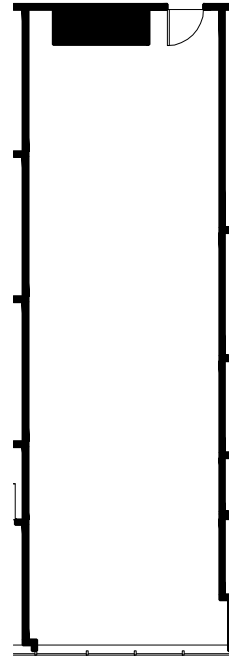

SCALE: VARIES



SKYLINE MADISON M.O.B.
VACANT 1 - 879 USF / 984 RSF

SKYLINE MADISON M.O.B.
MADISON, TENNESSEE

9019 OVERLOOK BLVD. . SUITE C-3 . BRENTWOOD, TN T - 615-620-4420 F - 615-620-4425 . www.seenashville.com