


KEY PLAN
NOT TO SCALE



RECORD DRAWING
NOT TO SCALE

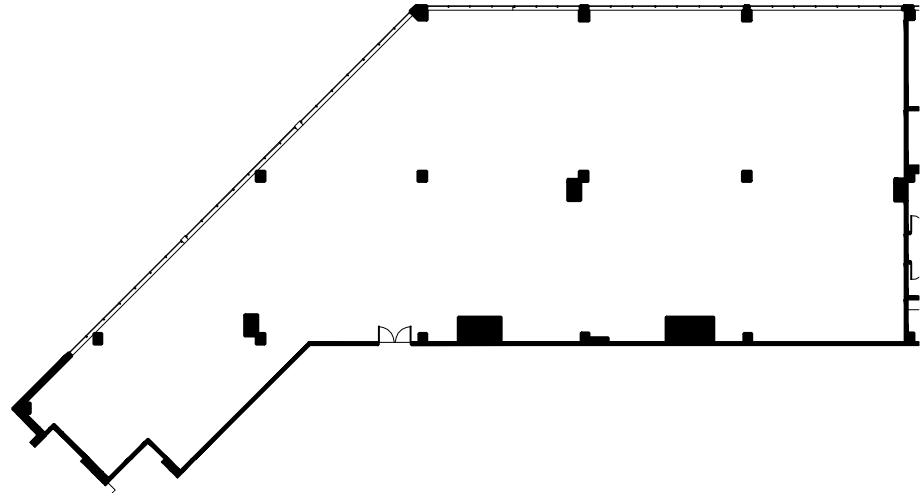

SCALE: VARIES



SKYLINE MADISON M.O.B.
MADISON, TENNESSEE

9010 OVERLOOK BLVD. . SUITE C-3 . BRENTWOOD, TN T - 615-620-4420 F - 615-620-4425 . www.seasashville.com

SKYLINE MADISON M.O.B.
VACANT - 8,328 USF / 9,327 RSF