


**KEY PLAN**  
**NOT TO SCALE**



**RECORD DRAWING**  
**1/16" SCALE**

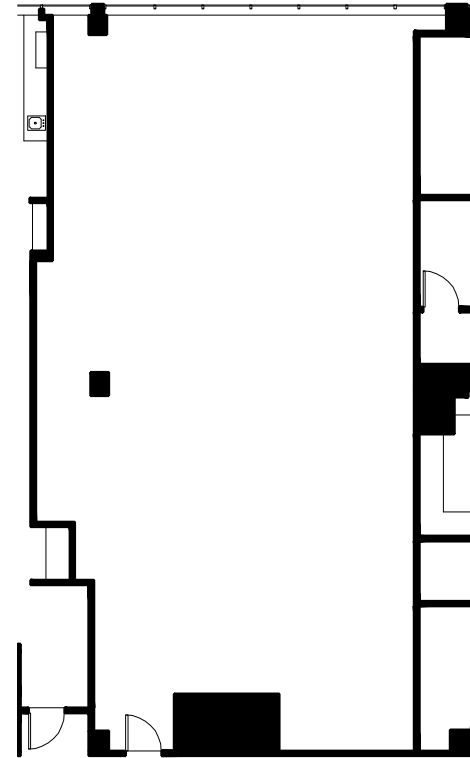

**SKYLINE MADISON M.O.B.**  
**VACANT 2 - 1,875 USF / 2,100 RSF**

SCALE: VARIES



SKYLINE MADISON M.O.B.  
MADISON, TENNESSEE

9019 OVERLOOK BLVD. . SUITE C-3 . BRENTWOOD, TN T - 615-626-4420 F - 615-626-4425 . [www.aenashville.com](http://www.aenashville.com)