


**KEY PLAN  
NOT TO SCALE**



**RECORD DRAWING  
1/16" SCALE**

**SKYLINE MADISON M.O.B.  
CONFERENCE ROOM (MAGNOLIA A & B) -  
3,912 USF / 4,381 RSF**

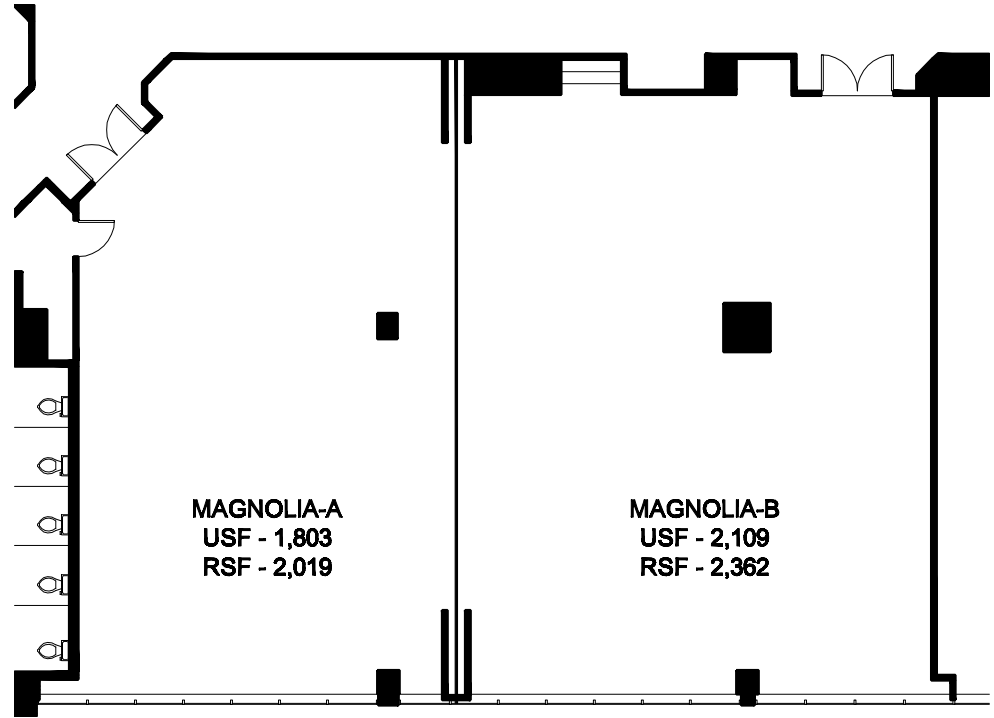

SCALE: VARIES



SKYLINE MADISON M.O.B.  
MADISON, TENNESSEE

9019 OVERLOOK BLVD. . SUITE C-3 . BRENTWOOD, TN T - 615-626-4420 F - 615-626-4425 . [www.aenashville.com](http://www.aenashville.com)