


**KEY PLAN**  
NOT TO SCALE



**RECORD DRAWING**  
NOT TO SCALE

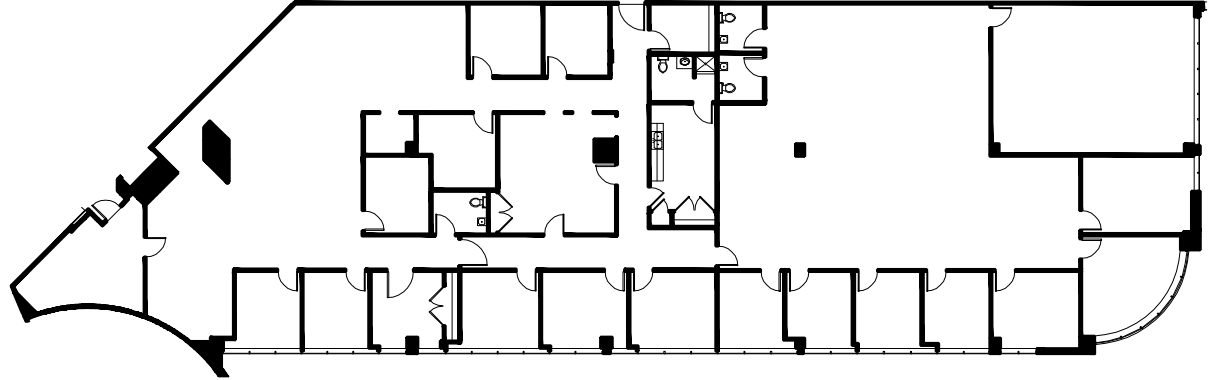

SCALE: VARIES



**SKYLINE MADISON M.O.B.**  
**SUITE 100 - 8,506 USF / 9,527 RSF**

SKYLINE MADISON M.O.B.  
MADISON, TENNESSEE

0010 OVERLOOK BLVD. . SUITE C-3 . BRENTWOOD, TN T - 615-620-4420 F - 615-620-4425 . [www.senseshville.com](http://www.senseshville.com)