


KEY PLAN
NOT TO SCALE



RECORD DRAWING
1/16" SCALE

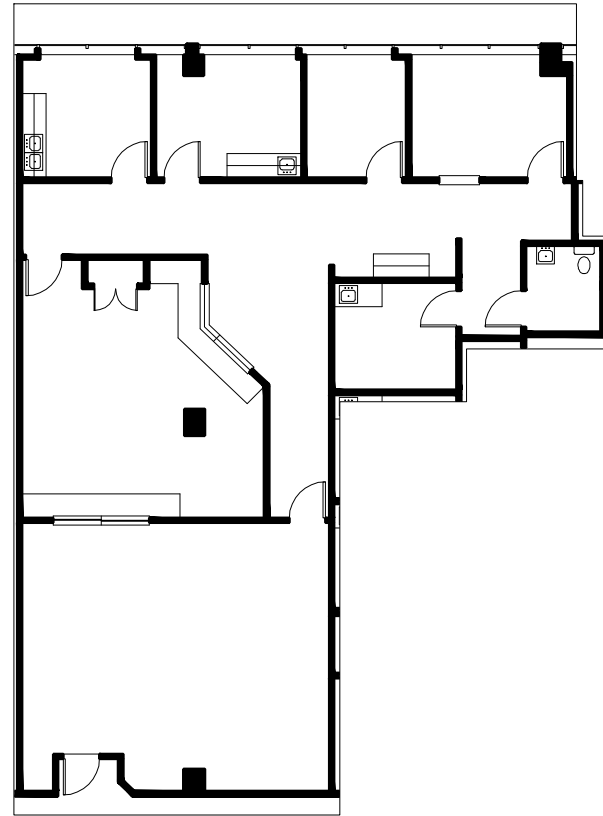

SKYLINE MADISON M.O.B.
SUITE 150A - 2,161 USF / 2,420 RSF

SCALE: VARIES



SKYLINE MADISON M.O.B.
MADISON, TENNESSEE

9019 OVERLOOK BLVD. . SUITE C-3 . BRENTWOOD, TN T - 615-620-4420 F - 615-620-4425 . www.aenashville.com