


KEY PLAN
NOT TO SCALE



RECORD DRAWING
1/16" SCALE

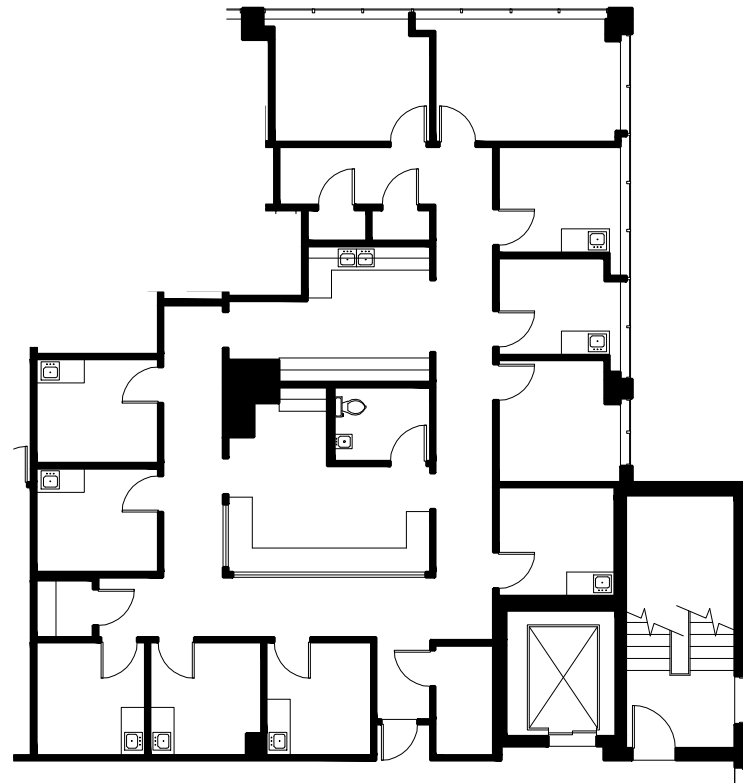

SCALE: VARIES



SKYLINE MADISON M.O.B.
SUITE 150B - 2,364 USF / 2,648 RSF

SKYLINE MADISON M.O.B.
MADISON, TENNESSEE

9010 OVERLOOK BLVD. . SUITE C-3 . BRENTWOOD, TN T - 615-620-4420 F - 615-620-4425 . www.eenschville.com