


**KEY PLAN
NOT TO SCALE**



**RECORD DRAWING
1/16" SCALE**

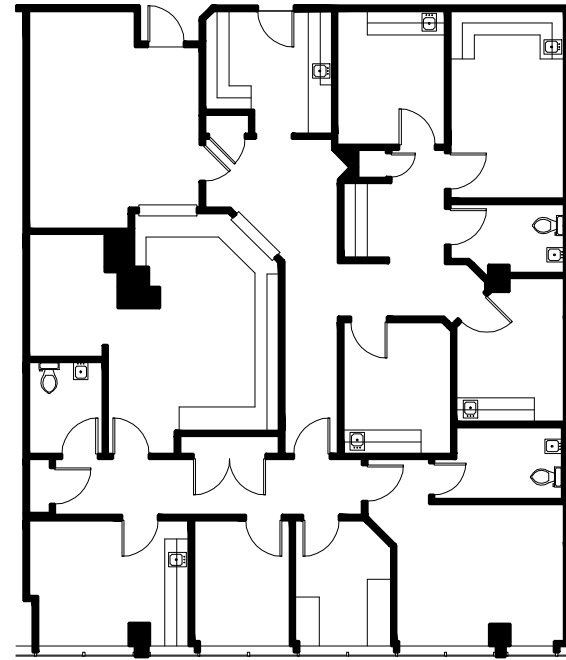

SCALE: VARIES



**SKYLINE MADISON M.O.B.
SUITE 240 - 2,409 USF / 2,698 RSF**

SKYLINE MADISON M.O.B.
MADISON, TENNESSEE

9019 OVERLOOK BLVD. . SUITE C-3 . BRENTWOOD, TN T - 615-820-4420 F - 615-820-4425 . www.sensshville.com