


KEY PLAN
NOT TO SCALE



RECORD DRAWING
1/16" SCALE

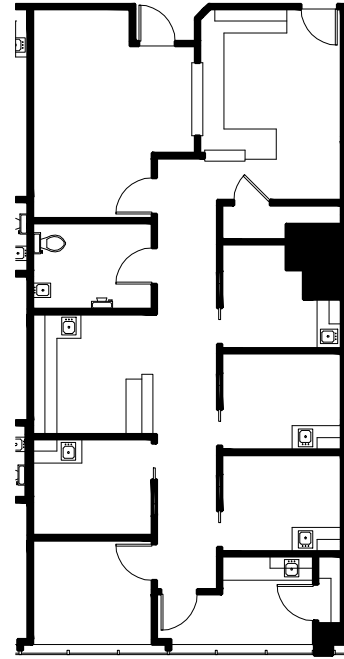

SCALE: VARIES



SKYLINE MADISON M.O.B.
SUITE 260 - 1,397 USF / 1,565 RSF

SKYLINE MADISON M.O.B.
MADISON, TENNESSEE

9919 OVERLOOK BLVD. . SUITE C-3 . BRENTWOOD, TN T - 615-620-4420 F - 615-620-4425 . www.aeeashville.com