


KEY PLAN
NOT TO SCALE



RECORD DRAWING
NOT TO SCALE

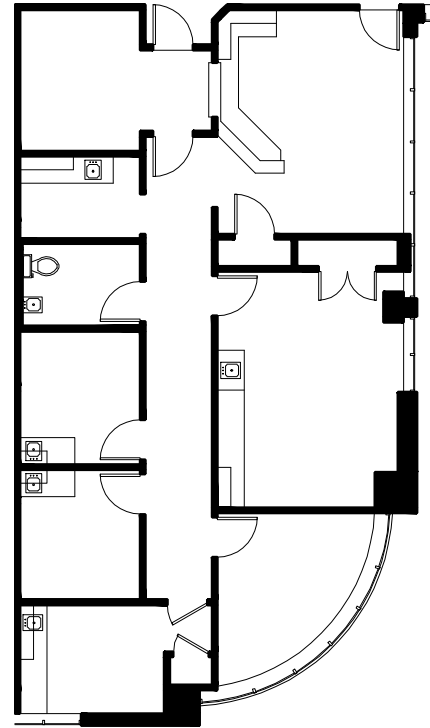

SCALE: VARIES



SKYLINE MADISON M.O.B.
SUITE 280 - 1,472 USF / 1,649 RSF

SKYLINE MADISON M.O.B.
MADISON, TENNESSEE

9019 OVERLOOK BLVD. . SUITE C-3 . BRENTWOOD, TN T - 615-826-4420 F - 615-826-4425 . www.seenashville.com