


KEY PLAN
NOT TO SCALE



RECORD DRAWING
NOT TO SCALE

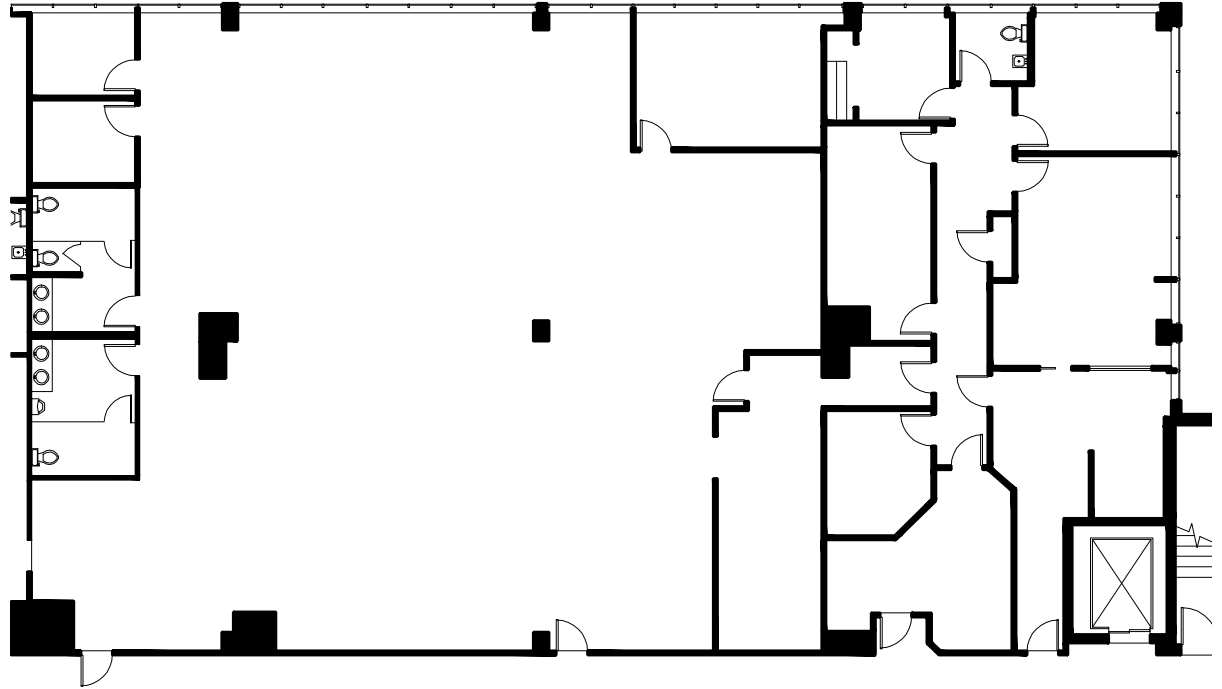

SCALE: VARIES



SKYLINE MADISON M.O.B.
MADISON, TENNESSEE

SKYLINE MADISON M.O.B.
SUITE 290 - 6,703 USF / 7,507 RSF

9010 OVERLOOK BLVD. . SUITE C-3 . BRENTWOOD, TN T - 615-820-4420 F - 615-820-4425 . www.aenashville.com