


**KEY PLAN  
NOT TO SCALE**



**RECORD DRAWING  
1/16" SCALE**

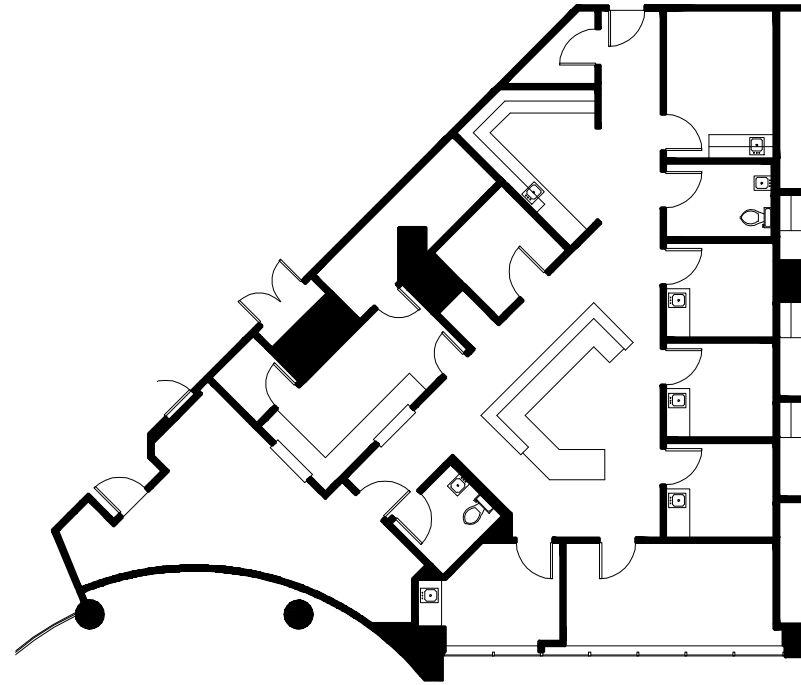

**SKYLINE MADISON M.O.B.  
SUITE 300 - 2,048 USF / 2,294 RSF**

SCALE: VARIES



SKYLINE MADISON M.O.B.  
MADISON, TENNESSEE

9019 OVERLOOK BLVD. . SUITE C-3 . BRENTWOOD, TN T - 615-626-4420 F - 615-626-4425 . [www.seenashville.com](http://www.seenashville.com)