


**KEY PLAN
NOT TO SCALE**



**RECORD DRAWING
1/16" SCALE**

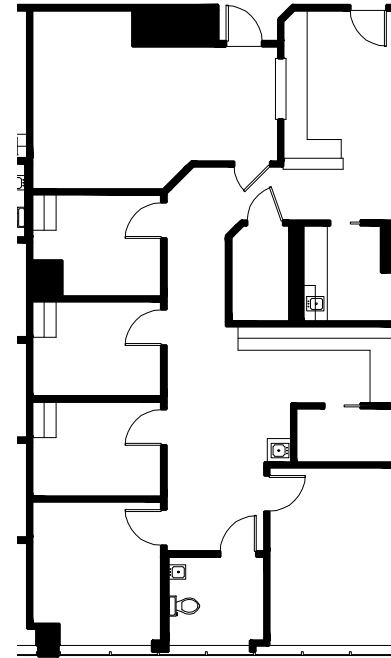

SCALE: VARIES



**SKYLINE MADISON M.O.B.
SUITE 320 - 1,638 USF / 1,835 RSF**

SKYLINE MADISON M.O.B.
MADISON, TENNESSEE

9819 OVERLOOK BLVD. . SUITE C-3 . BRENTWOOD, TN T - 615-620-4420 F - 615-620-4425 . www.aenashville.com