


**KEY PLAN
NOT TO SCALE**



**RECORD DRAWING
1/16" SCALE**

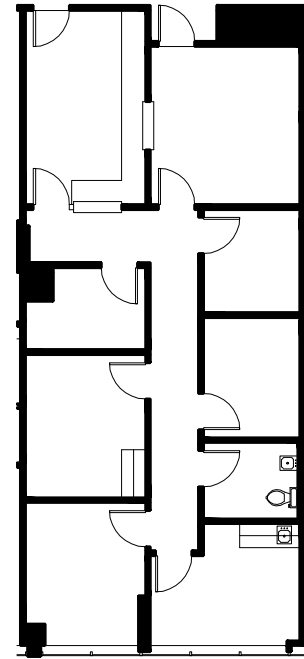

SCALE: VARIES



SKYLINE MADISON M.O.B.
MADISON, TENNESSEE

9919 OVERLOOK BLVD. . SUITE C-3 . BRENTWOOD, TN T - 615-626-4429 F - 615-626-4425 . www.aenashville.com

**SKYLINE MADISON M.O.B.
SUITE 340 - 1,245 USF / 1,394 RSF**