


**KEY PLAN  
NOT TO SCALE**



**RECORD DRAWING  
1/16" SCALE**

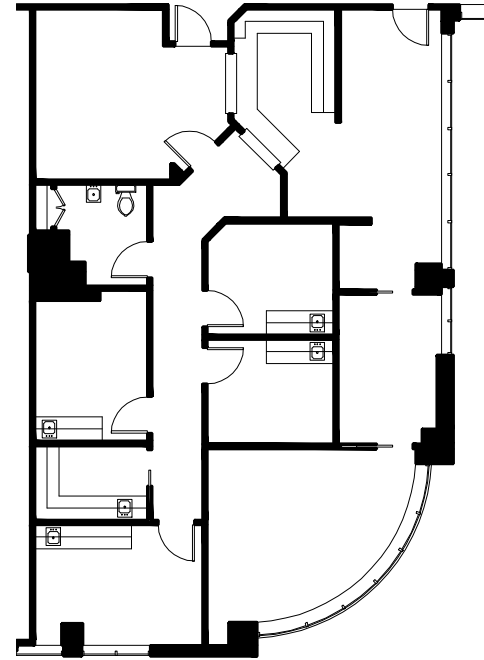

**SKYLINE MADISON M.O.B.  
SUITE 480 - 1,741 USF / 1,950 RSF**

SCALE: VARIES



SKYLINE MADISON M.O.B.  
MADISON, TENNESSEE

9019 OVERLOOK BLVD. . SUITE C-3 . BRENTWOOD, TN T - 615-626-4420 F - 615-626-4425 . www.aenashville.com