


**KEY PLAN
NOT TO SCALE**



**RECORD DRAWING
1/16" SCALE**

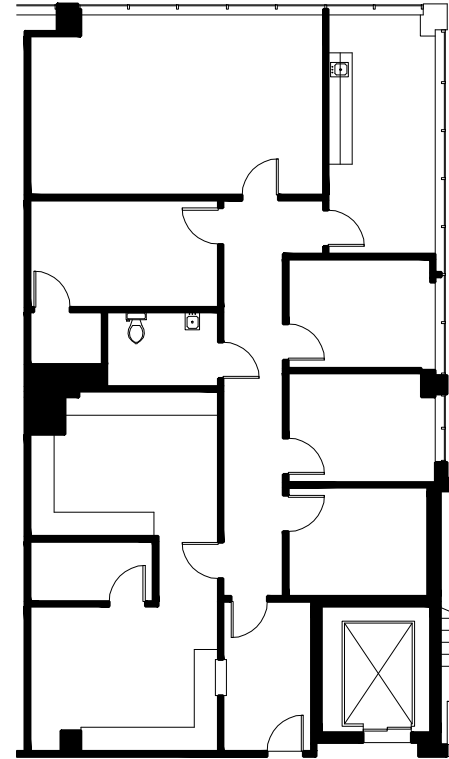

**SKYLINE MADISON M.O.B.
SUITE 490 - 1,985 USF / 2,223 RSF**

SCALE: VARIES



SKYLINE MADISON M.O.B.
MADISON, TENNESSEE

9019 OVERLOOK BLVD. . SUITE C-3 . BRENTWOOD, TN T - 615-626-4420 F - 615-626-4425 . www.aenashville.com