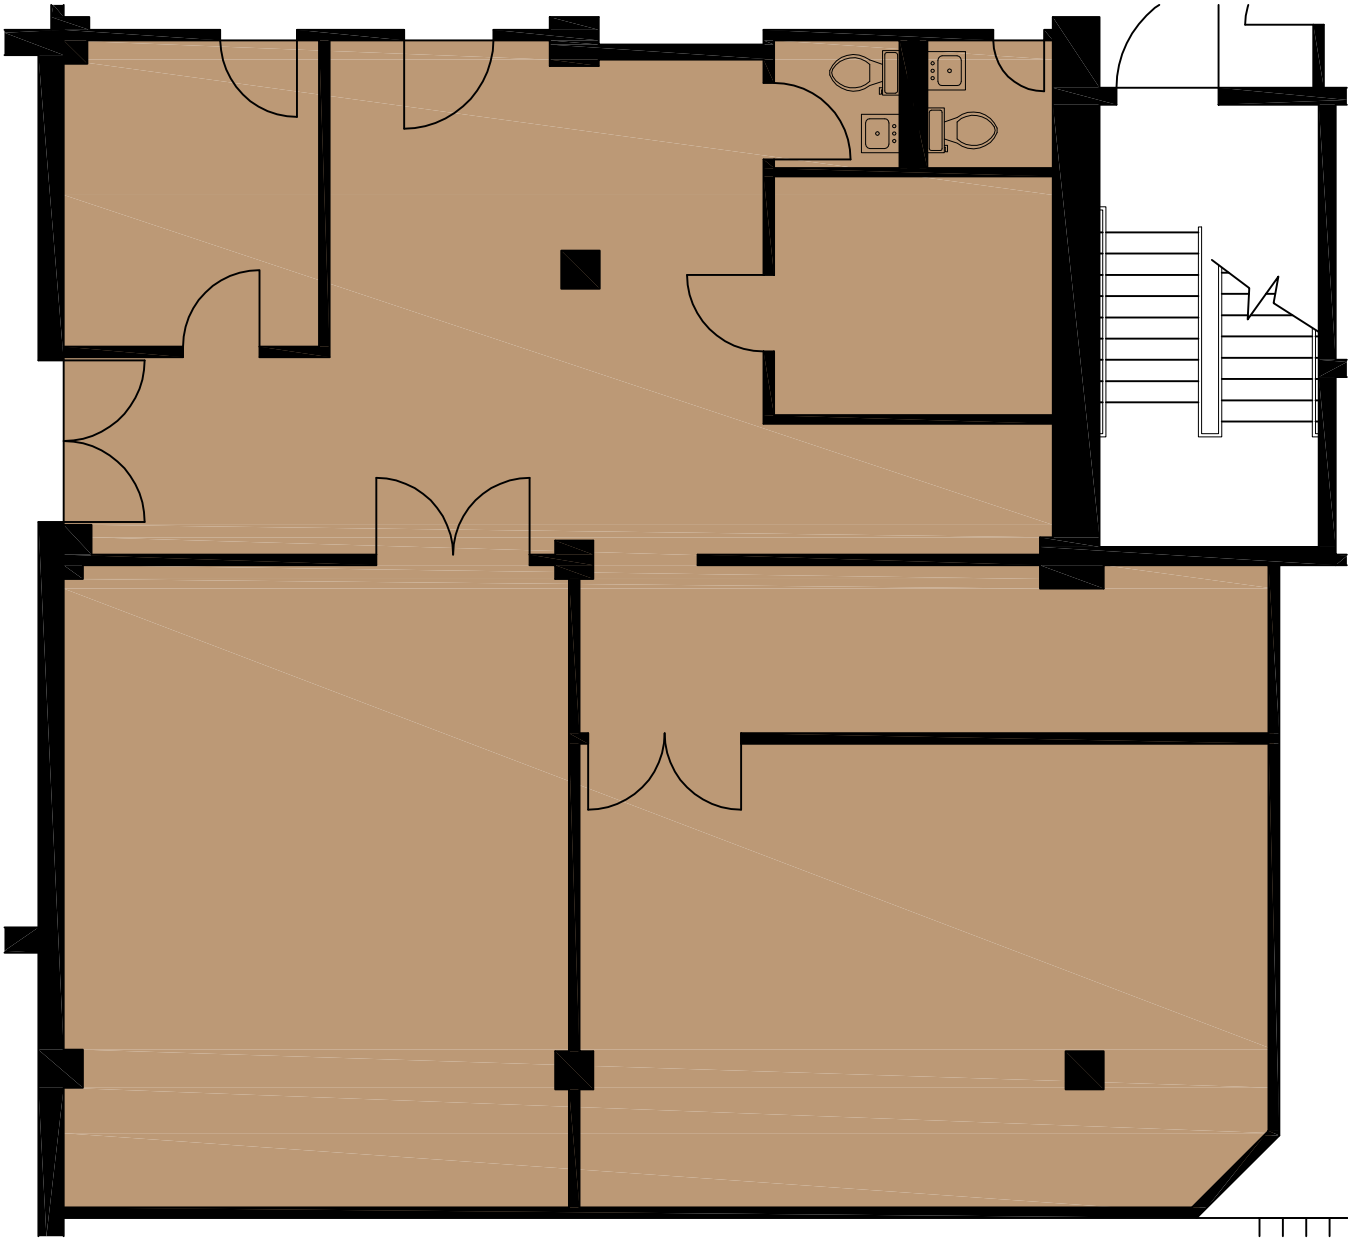

RECORD DRAWING
SCALE: 1/8" = 1'-0"

KEY PLAN
NOT TO SCALE

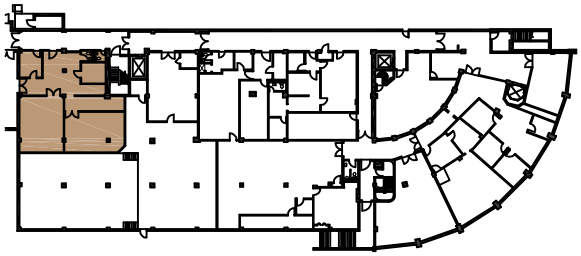

HORIZON MEDICAL CENTER - WEST MOB
SUITE 070 - 1,982 USF / 2,220 RSF

SCALE: VARIES

* R.S.F. SHOWN IS BASED ON A 12% MARKET FACTOR.

HORIZON MEDICAL - WEST MOB
111 HIGHWAY 70 EAST
DICKSON, TENNESSEE

ARCHITECTURAL ENVIRONMENTS
ARCHITECTURE ■ INTERIOR DESIGN
9019 OVERLOOK BLVD . SUITE C-3 . BRENTWOOD, TN T - 615-620-4420 F - 615-620-4425 . www.aenashville.com